
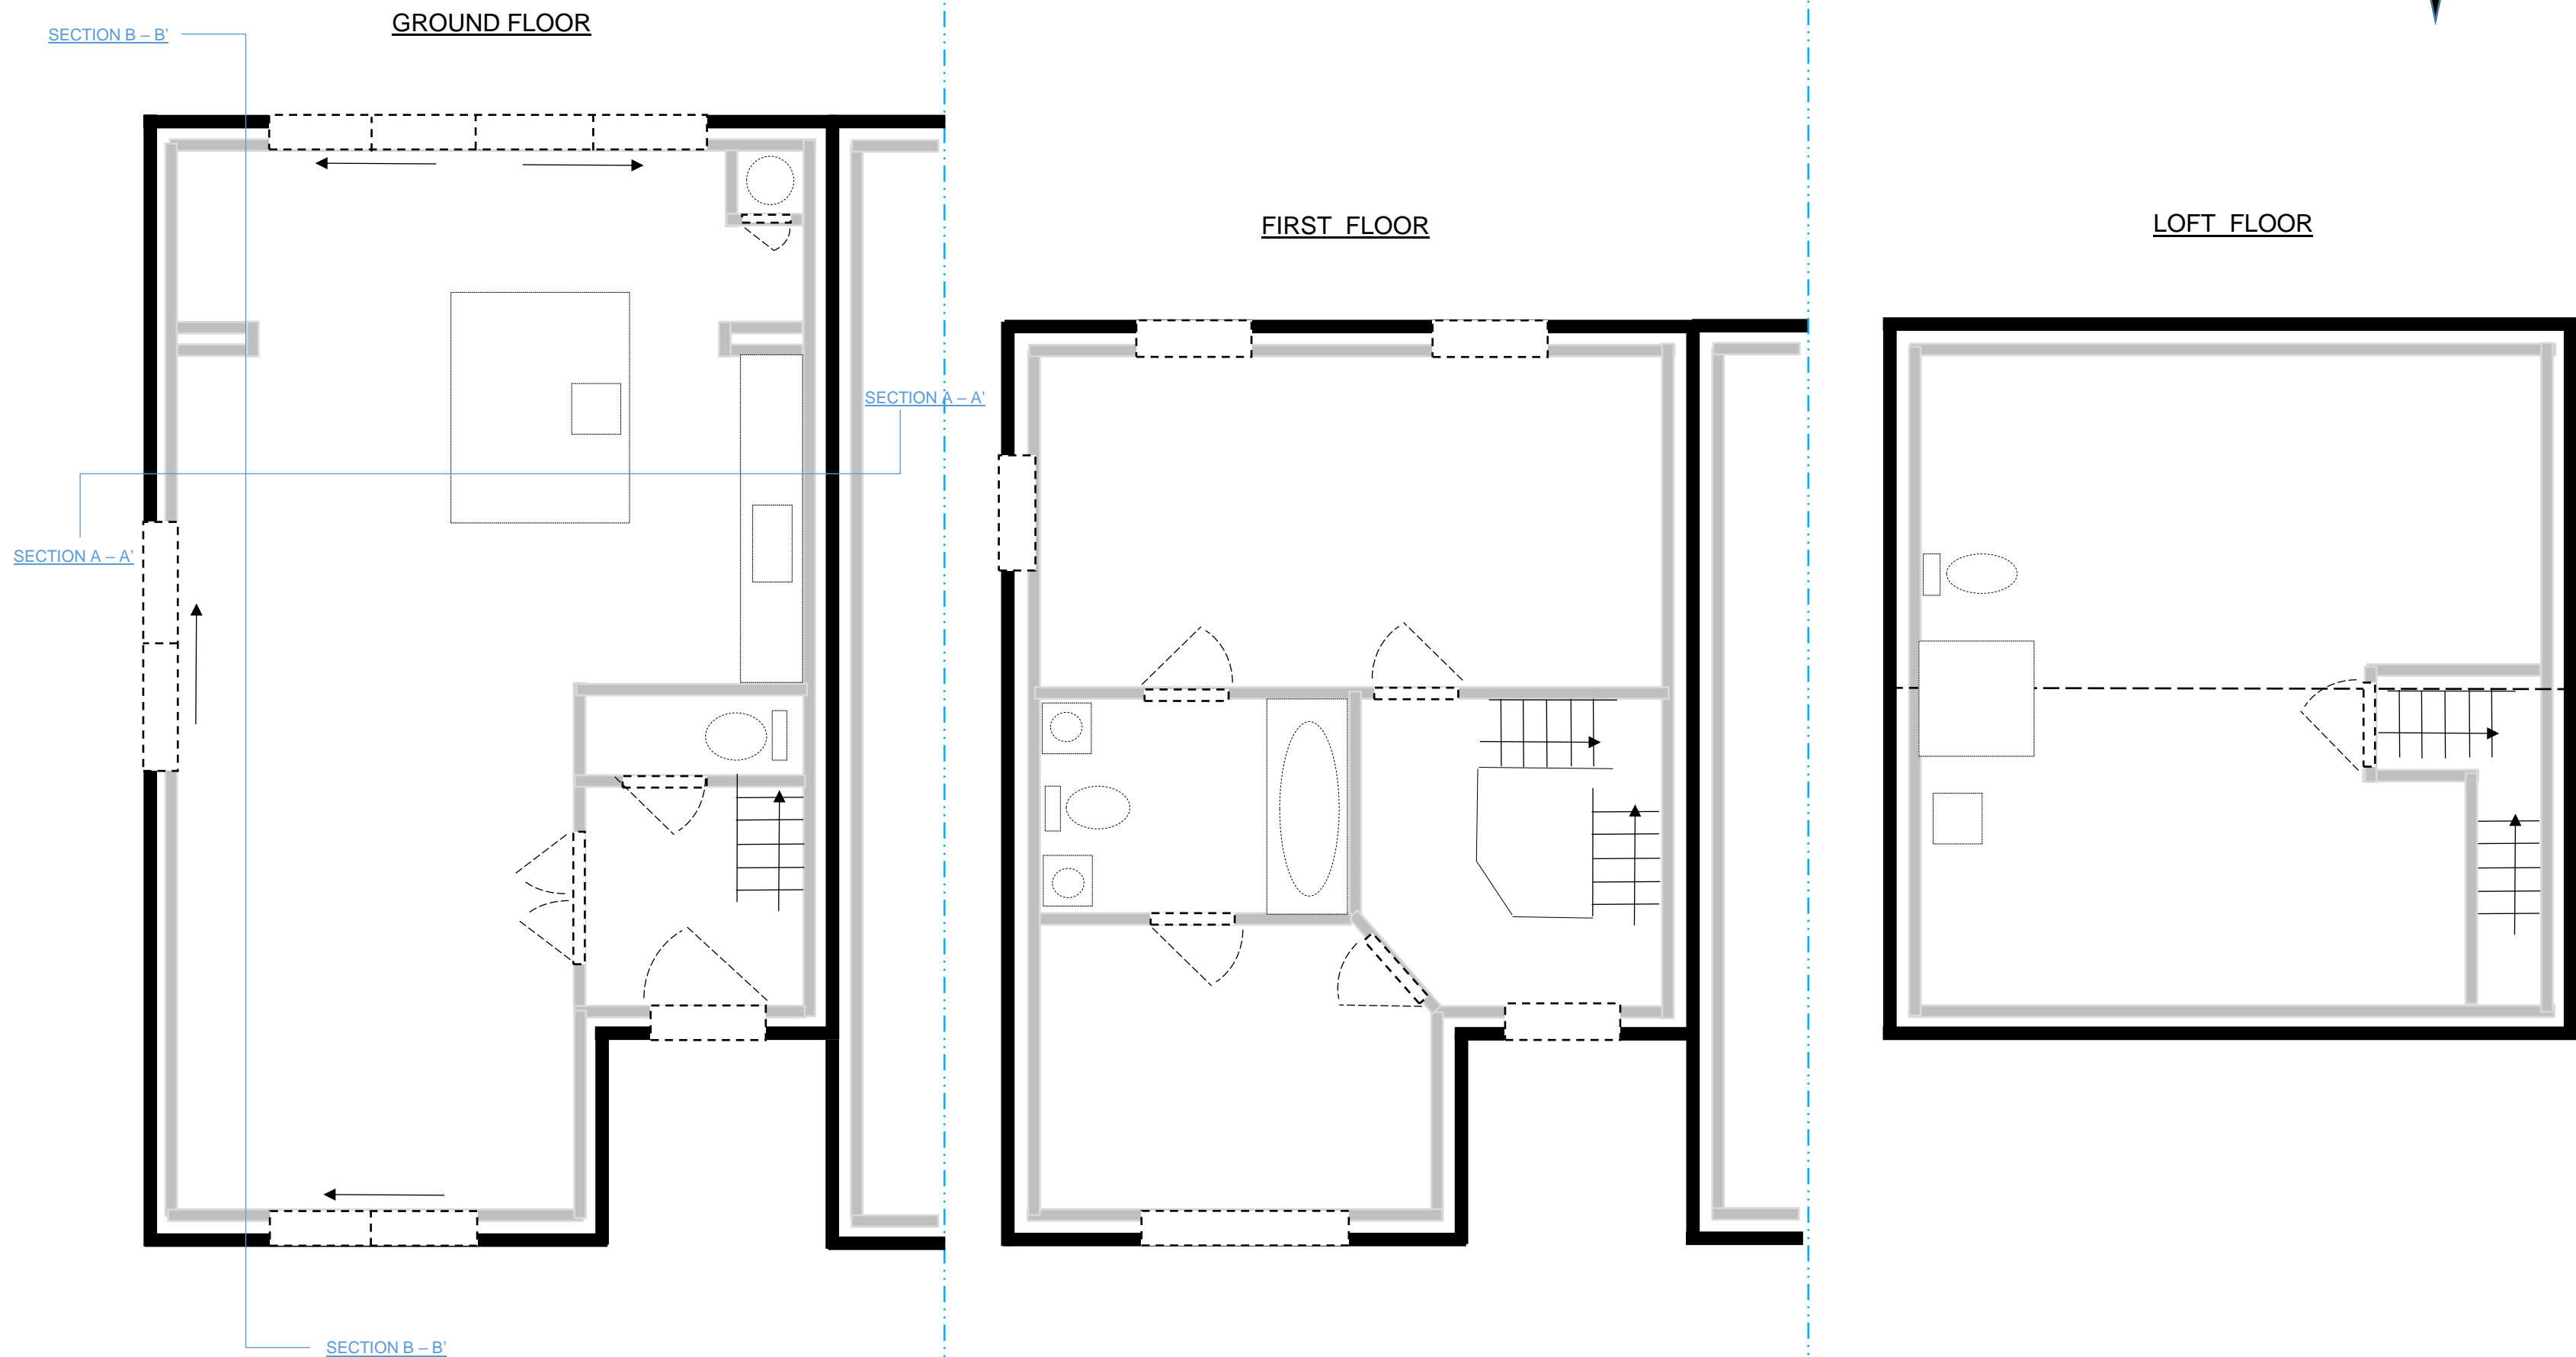


AS BUILT PLAN VIEW FOR SAP / EPC CALCULATIONS

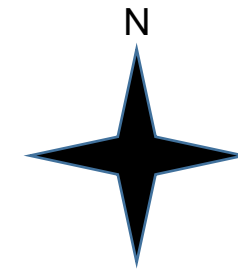

ASSOCIATED DRAWINGS	
No.	TITLE
020/002	AS BUILT - CROSS SECTIONS

- NOTES**
- ALL DIMENSIONS ARE IN METRES UNLESS OTHERWISE STATED.
 - DIMENSIONS ARE TO BE SCALED FROM THIS DRAWING REPRODUCED ON A2 OR GREATER FORMATS ONLY.
 - THIS DRAWING IS TO BE READ IN CONJUNCTION WITH ALL ASSOCIATED DRAWINGS & THE SPECIFICATION / GENERAL INSTRUCTION.
 - AS BUILT BUILDING IS 9.8M IN LENGTH BY 6M IN WIDTH
 - GROUND FLOOR CEILING HEIGHT - 2.33M.
 - FIRST FLOOR CEILING HEIGHT - 2.23M.
 - SECOND FLOOR CEILING HEIGHT - 2.1M AT APEX.
 - PLANNING APPLICATION 20/02706 GRANTED ON 13 OCTOBER 2020.
 - BUILDING CONTROL NOTIFIED 14 JANUARY 2021.

SER	DESCRIPTION	AUTH	DATE

AMENDMENTS

Winsper
 Property Specialists
 01344 206 200
 enquiries @ winspergroup.com
 www.winspergroup.com
 Central Chambers
 48B High Street, Sunninghill, Berkshire, SL5 9NF


DRAWING No/CAD FILE	TWG/020/001
---------------------	-------------

--	--	--	--	--	--	--	--	--	--

SCALE	1:50
-------	------

AS BUILT PLAN VIEWS
 41 ELIZABETH GARDENS
 ASCOT, BERKSHIRE
 SL5 9BJ

CHECKED BY	DATE	SIG.
D WINSPER	20/12/21	
DRAWN BY	DATE	SIG.
D WINSPER	20/12/21	
SURVEYED	DATE	SIG.
D WINSPER	20/12/21	

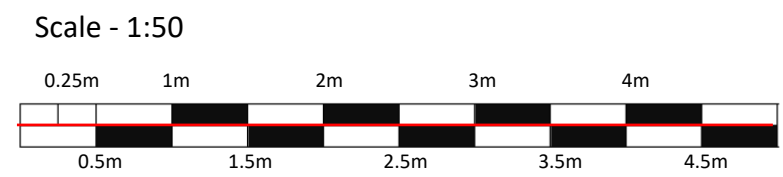

DO NOT SCALE FROM PICTURES